
LDK board


Operation box and pickup level

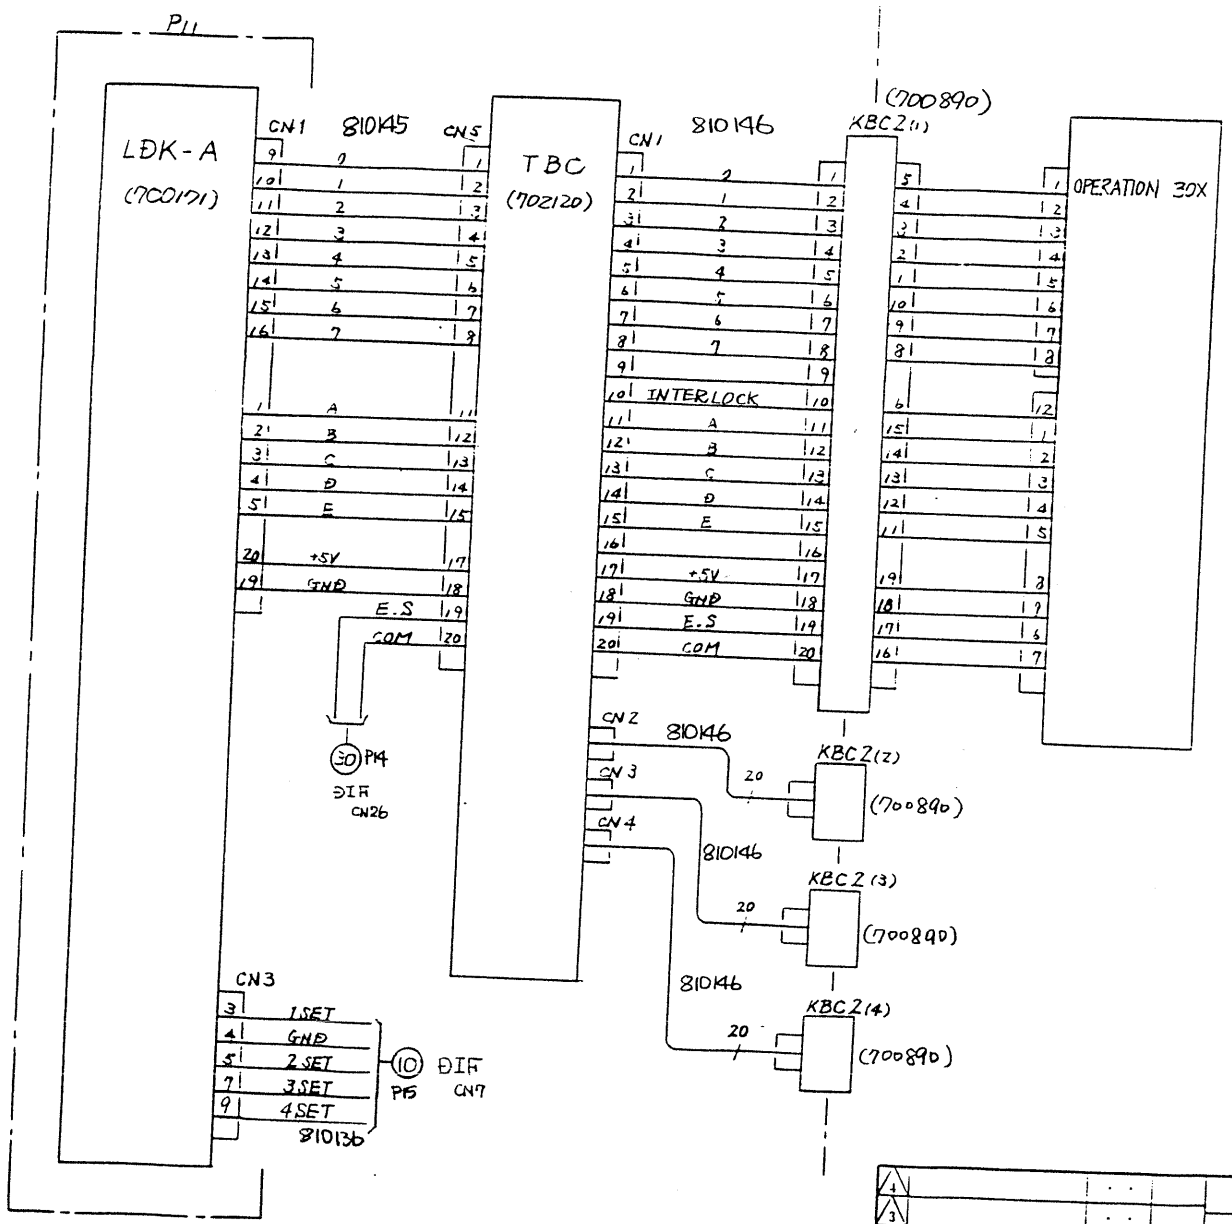

REVISIONS	DATE	REVD	MATERIAL	FINISH	DATE '92·12·25
					DWN BY T.UCHIDA
			SCALE / 3RD ANGLE PROJECTION	APPD BY	DSNG BY J.Suzuki
					CHKD BY M.KURATA
Tenryu Technics			TITLE MT-5600SQ ELEC CIRCUIT DWG	DWG NO. 910073	4/5

Conveyor soft stop


24, 21, 39, 23

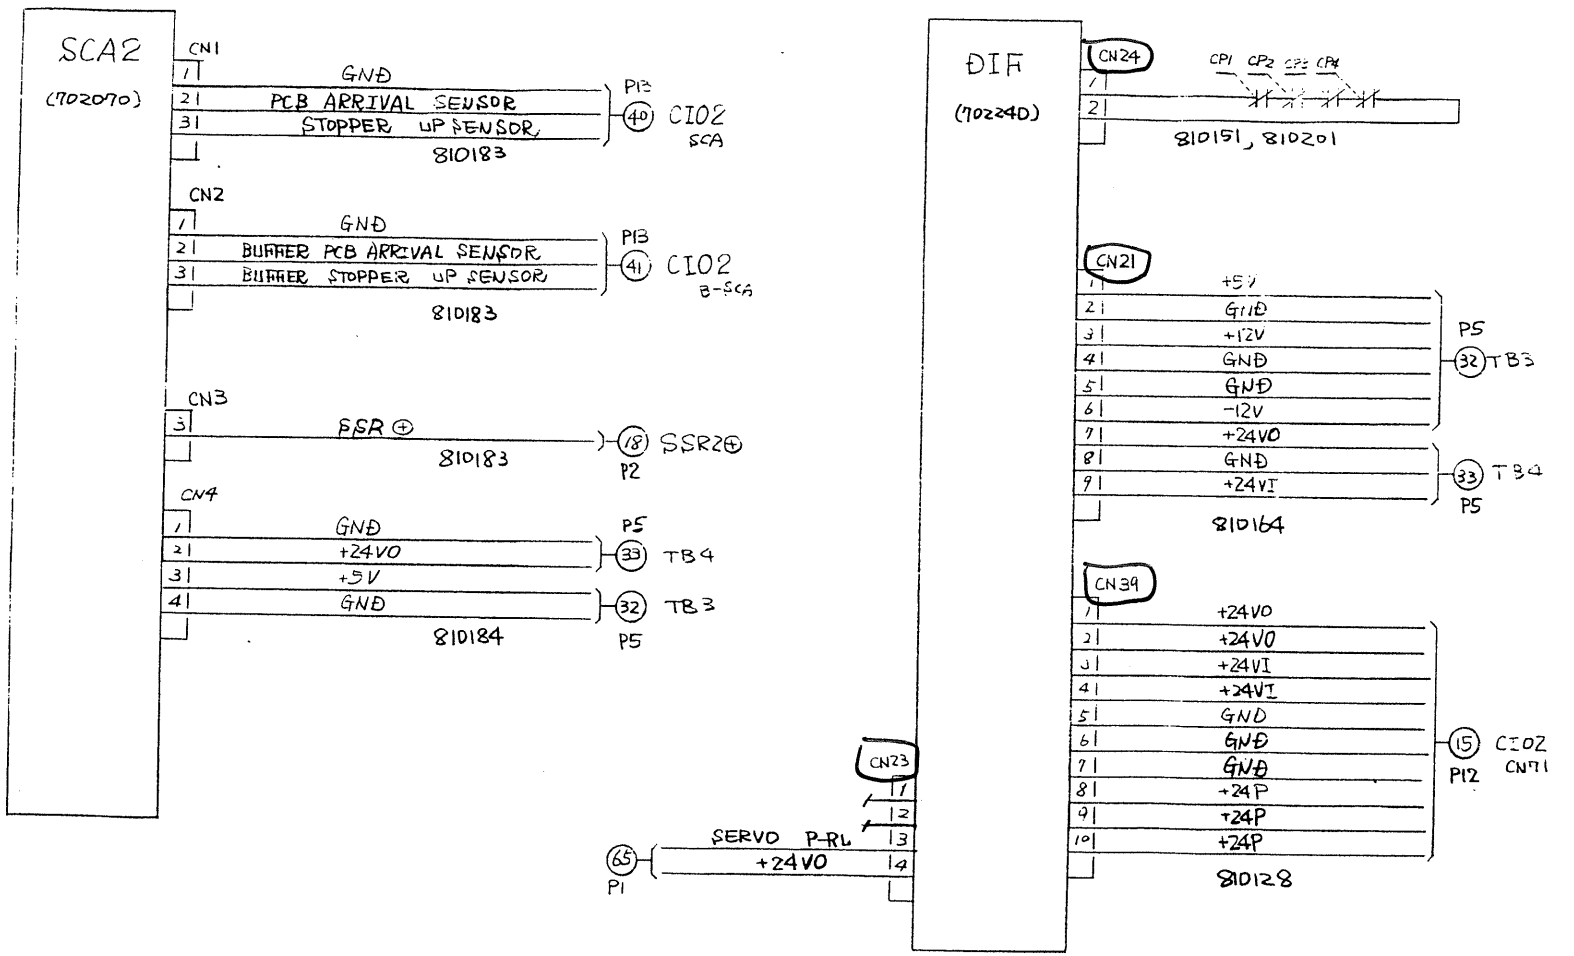

4				MATERIAL	FINISH	DATE 92·12·25
3						DWN BY T. UCHIDA
2				SCALE	3RD ANGLE PROJECTION	APPD BY
1						DSNG BY J. Suguki
	REVISIONS	DATE	REVD			CHKD BY M. KURATA
Tenryu Technics				TITLE MT-5600SQ ELEC. CIRCUIT DWG.		DWG. NO. 910073 10/25

head IO / head control θ-Axis / head rotation

42
41
43

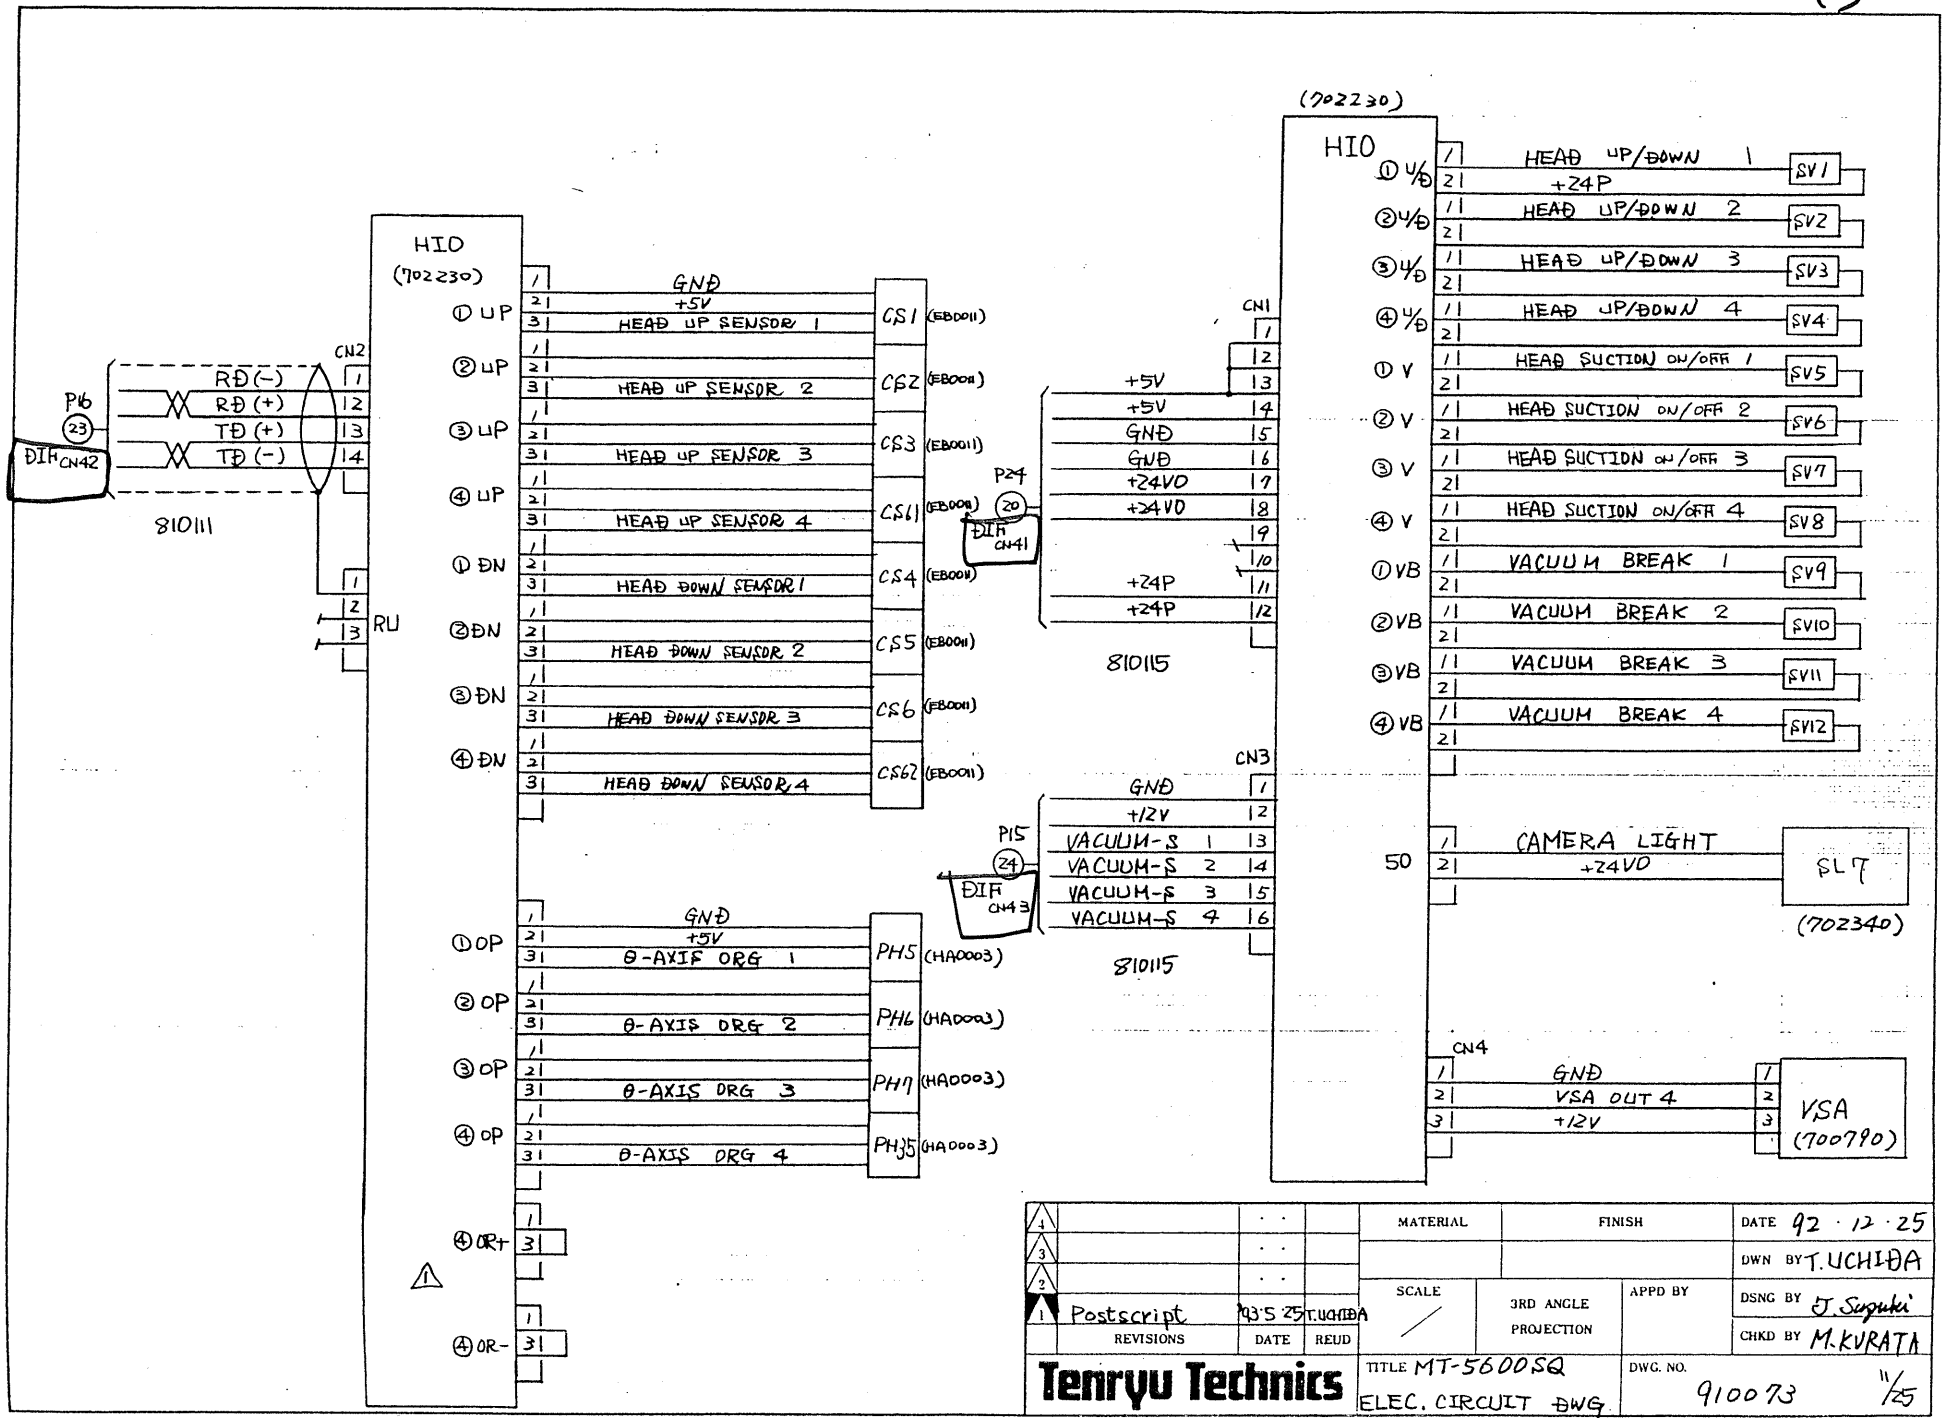


Control IO


36, 39, 37

diff 39 - (10PINS) Powers the Y limit sensors 25V x2

diff 44 - powers the X lmts sensor

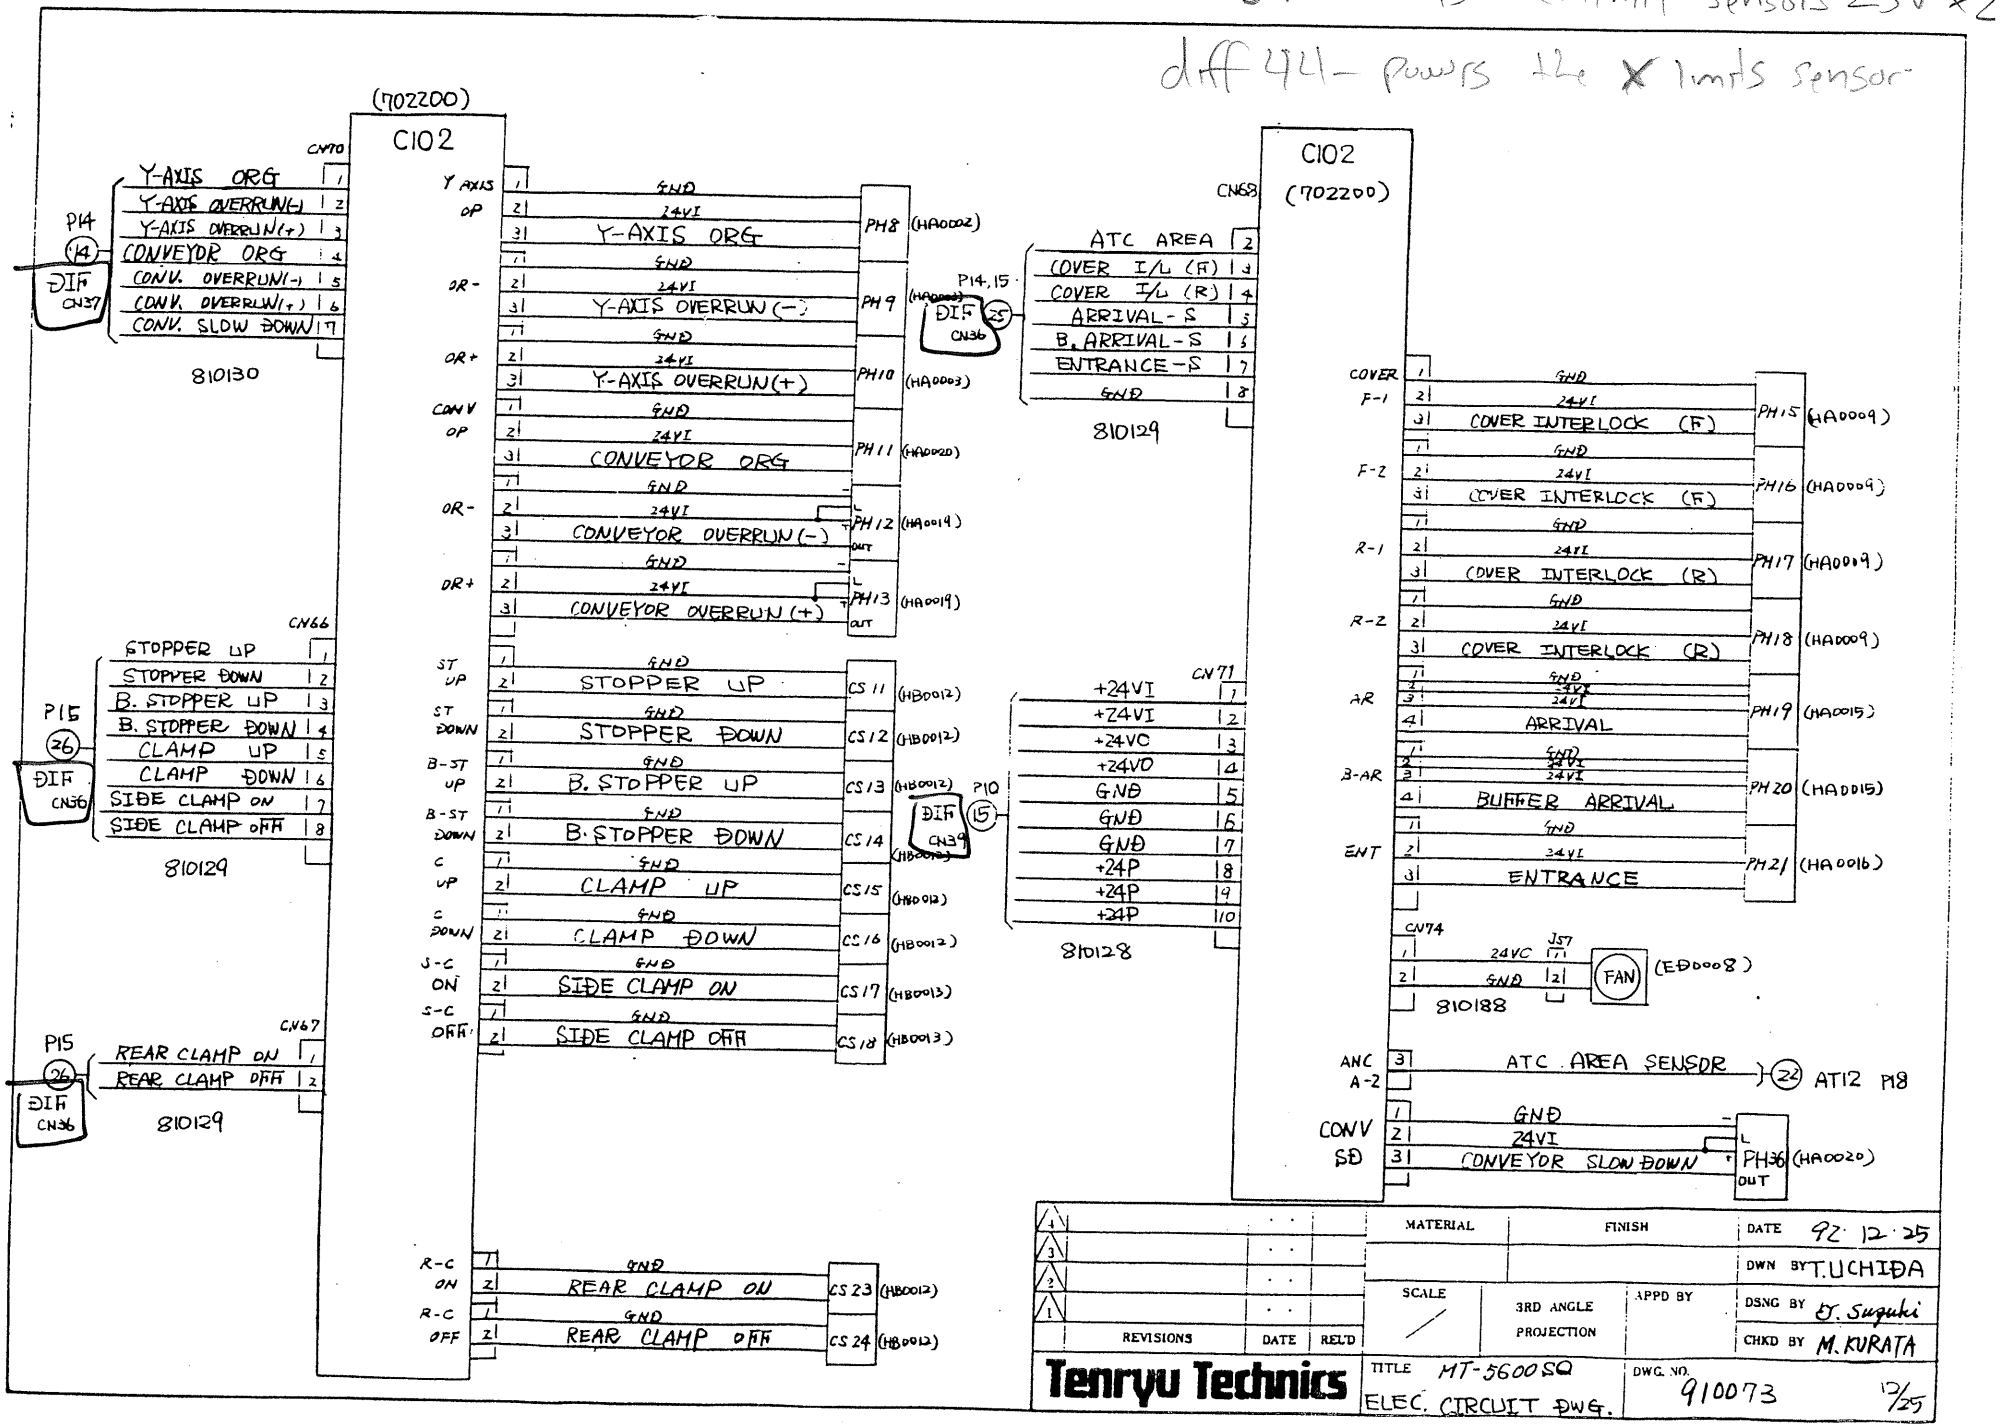

Control IO　　C102- Board clamping sensors　　37, 38

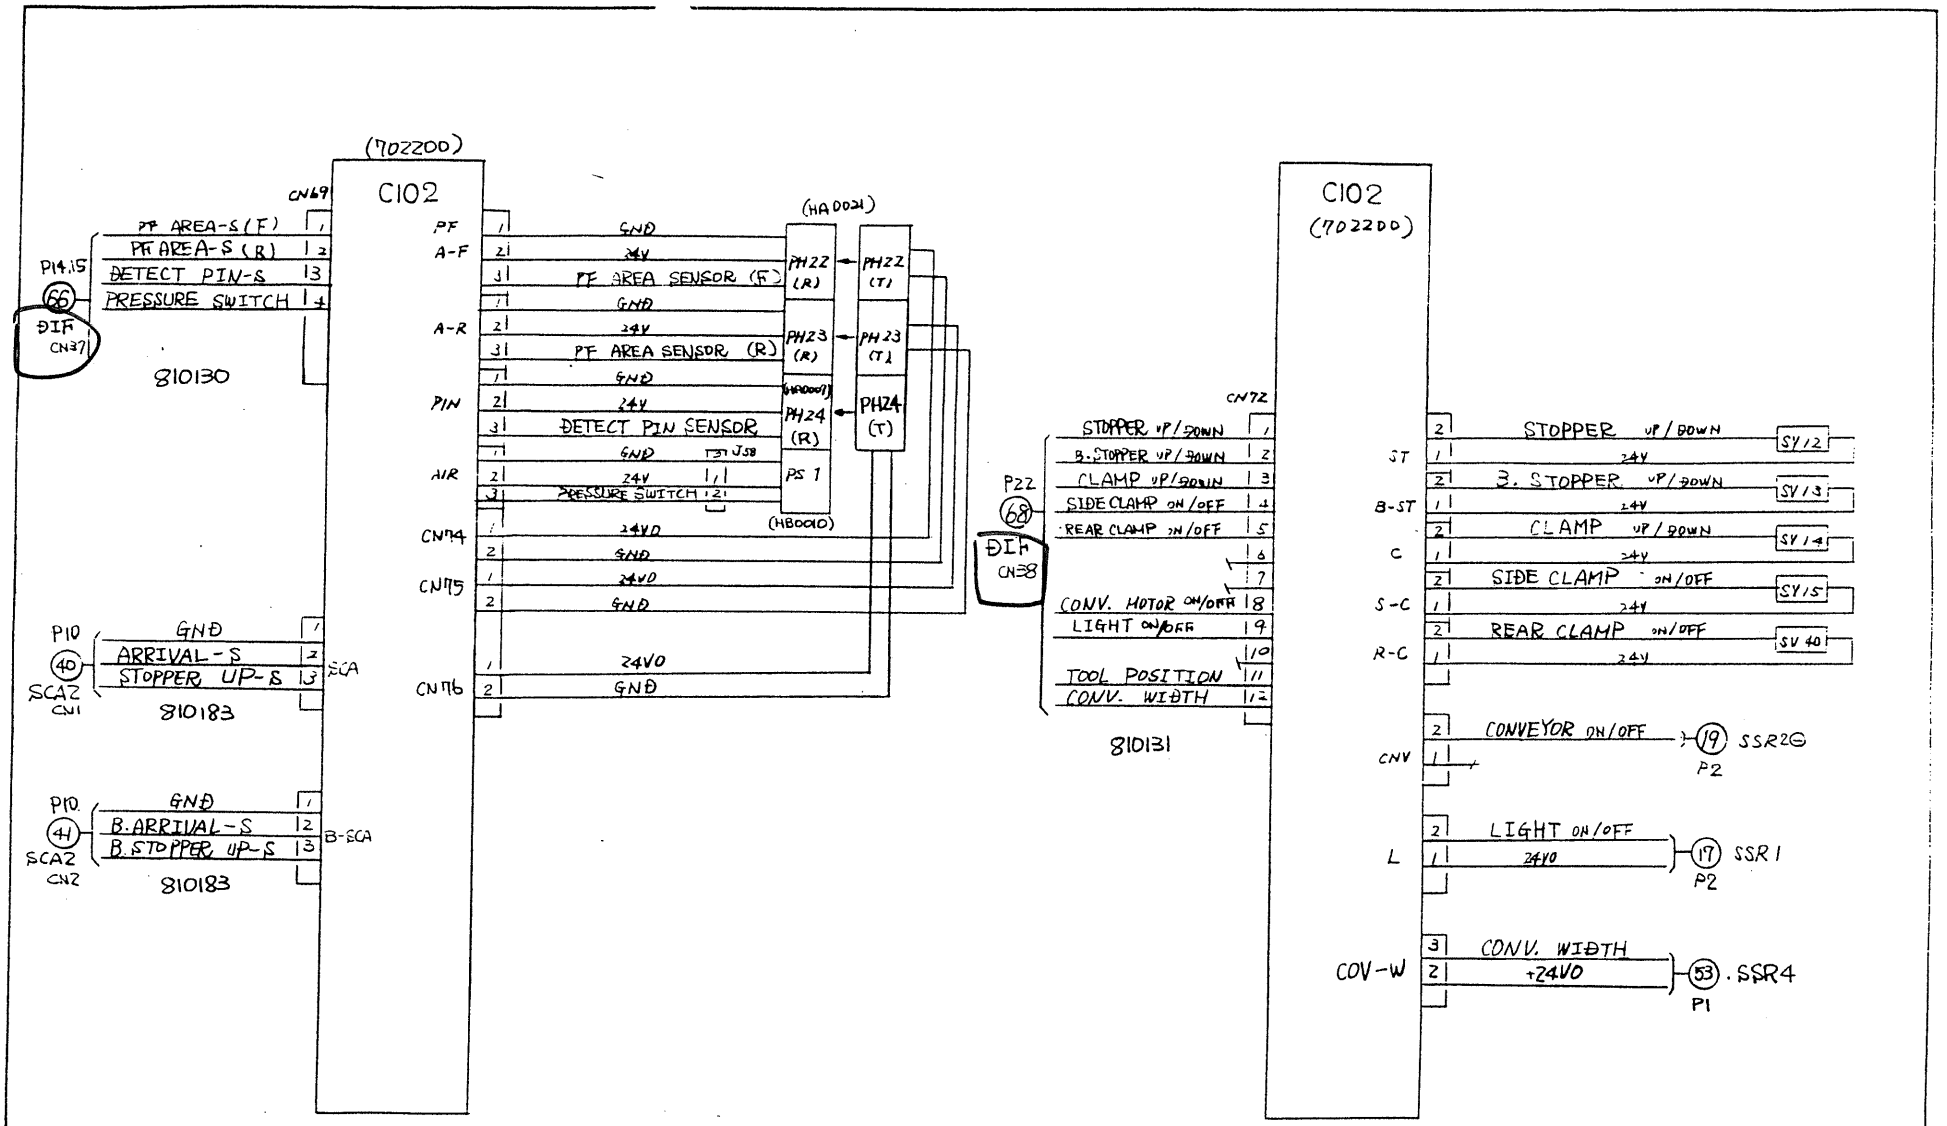

REVISIONS	DATE	REVD

MATERIAL　　FINISH　　DATE 92·12·26

SCALE　　3RD ANGLE PROJECTION　　APPD BY　　DWN BY T.UCHIDA　　DSNG BY J. Suzuki　　CHKD BY M.KURATA


Tenryu Technics

TITLE MT-5600SQ ELEC. CIRCUIT DWG.

DWG. NO. 910073　　13/25

DO 6 drive output board clamping, heads

38, 3-B, 33, ~~49~~, 32

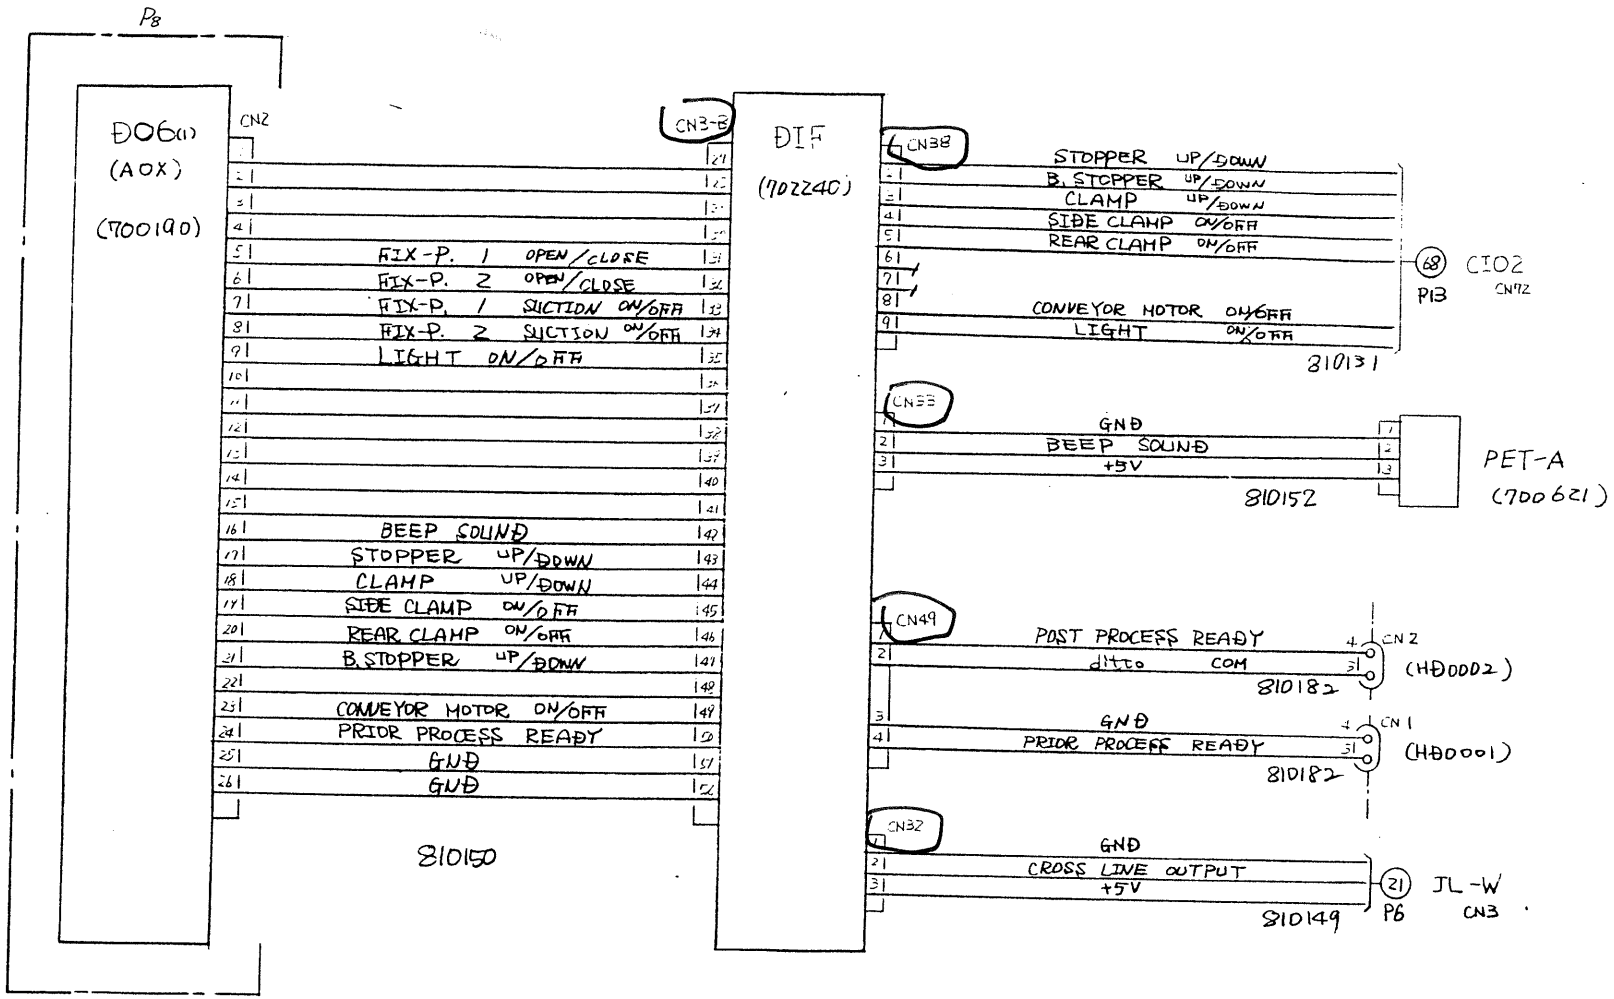

REVISIONS	DATE	REUD
4		
3		
2		
1		

MATERIAL	FINISH	DATE	92·12·26
		DWN BY	T. UCHIDA
SCALE /	3RD ANGLE PROJECTION	APPD BY	
		DSNG BY	J. Suzuki
		CHKD BY	M. KURATA

Tenryu Technics


TITLE MT-5600SQ ELEC. CIRCUIT DWG.

DWG. NO. 910073

22/25

3-A, 28, 29, ~~45~~
42, 44, ~~22~~

421 power sX axis limit sensor

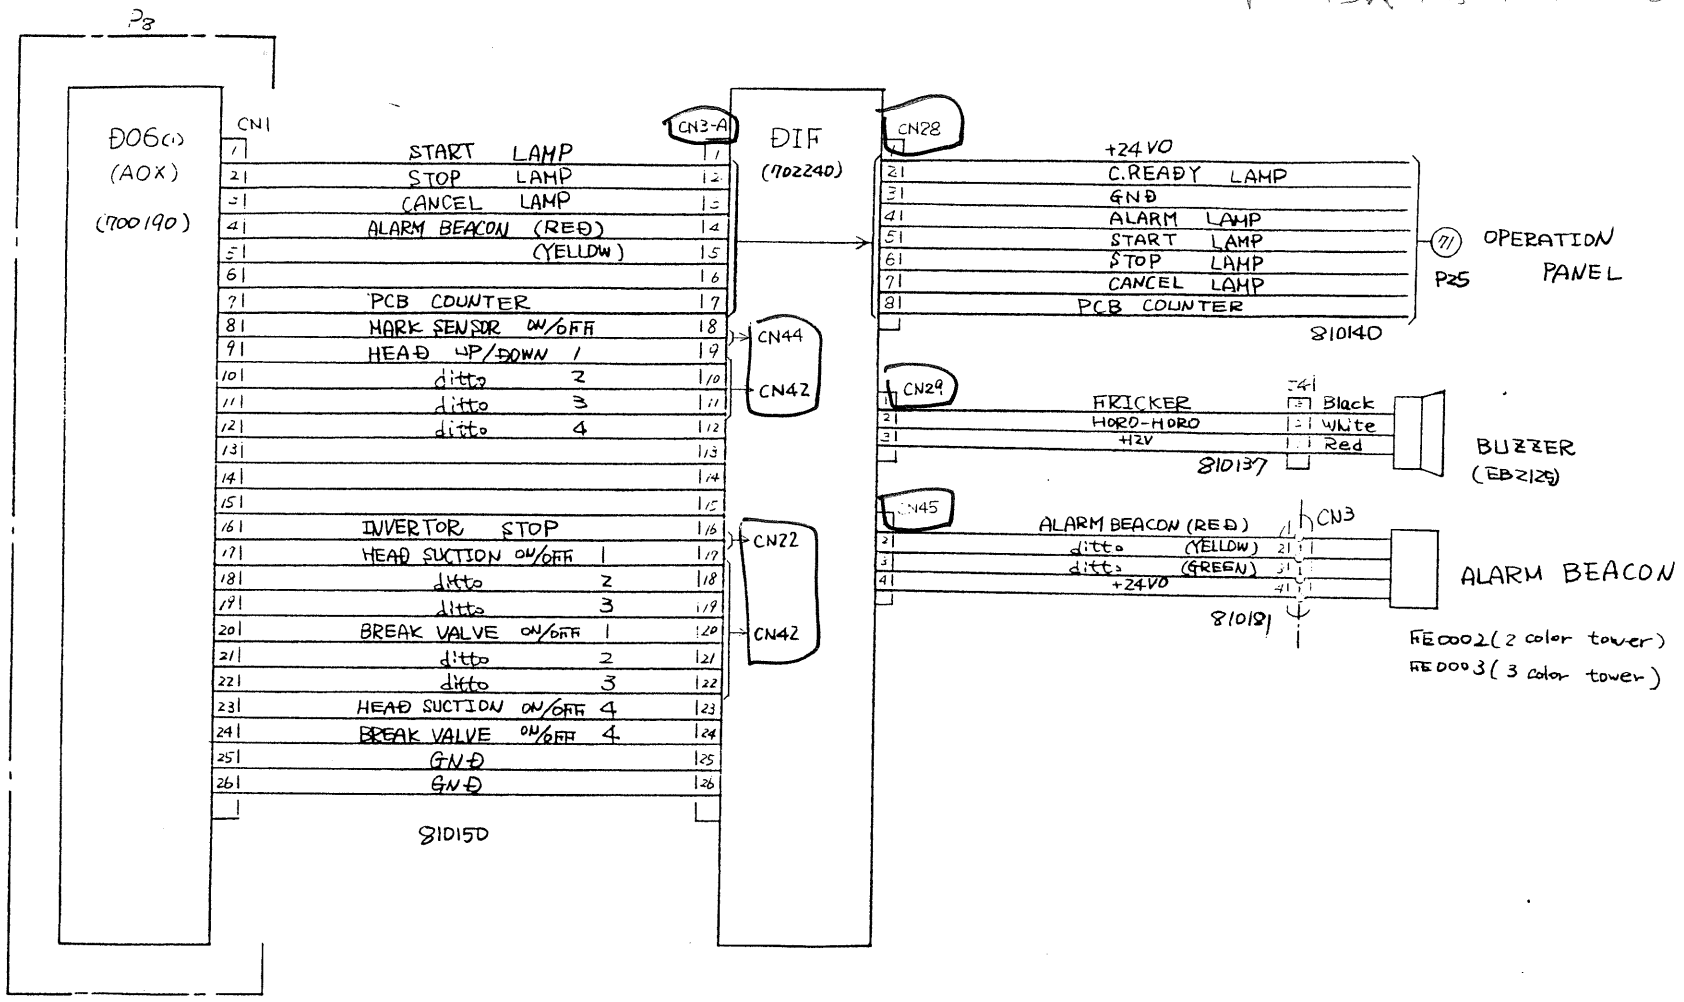


4			MATERIAL	FINISH	DATE 92 · 12 · 26	
3					DWN BY T. UCHIDA	
2			SCALE	3RD ANGLE PROJECTION	APPD BY	DSNG BY J. Suzuki
1						CHKD BY M. KURATA
	REVISIONS	DATE	REVD			
Tenryu Technics				TITLE MT-5600S2 ELEC. CIRCUIT DWG.	DWG. NO. 910073	21/25

Data In Board ATC Sensors

1-A, 37, 36, 27-A, 25, 26, 44

44 is X-axis limit!!

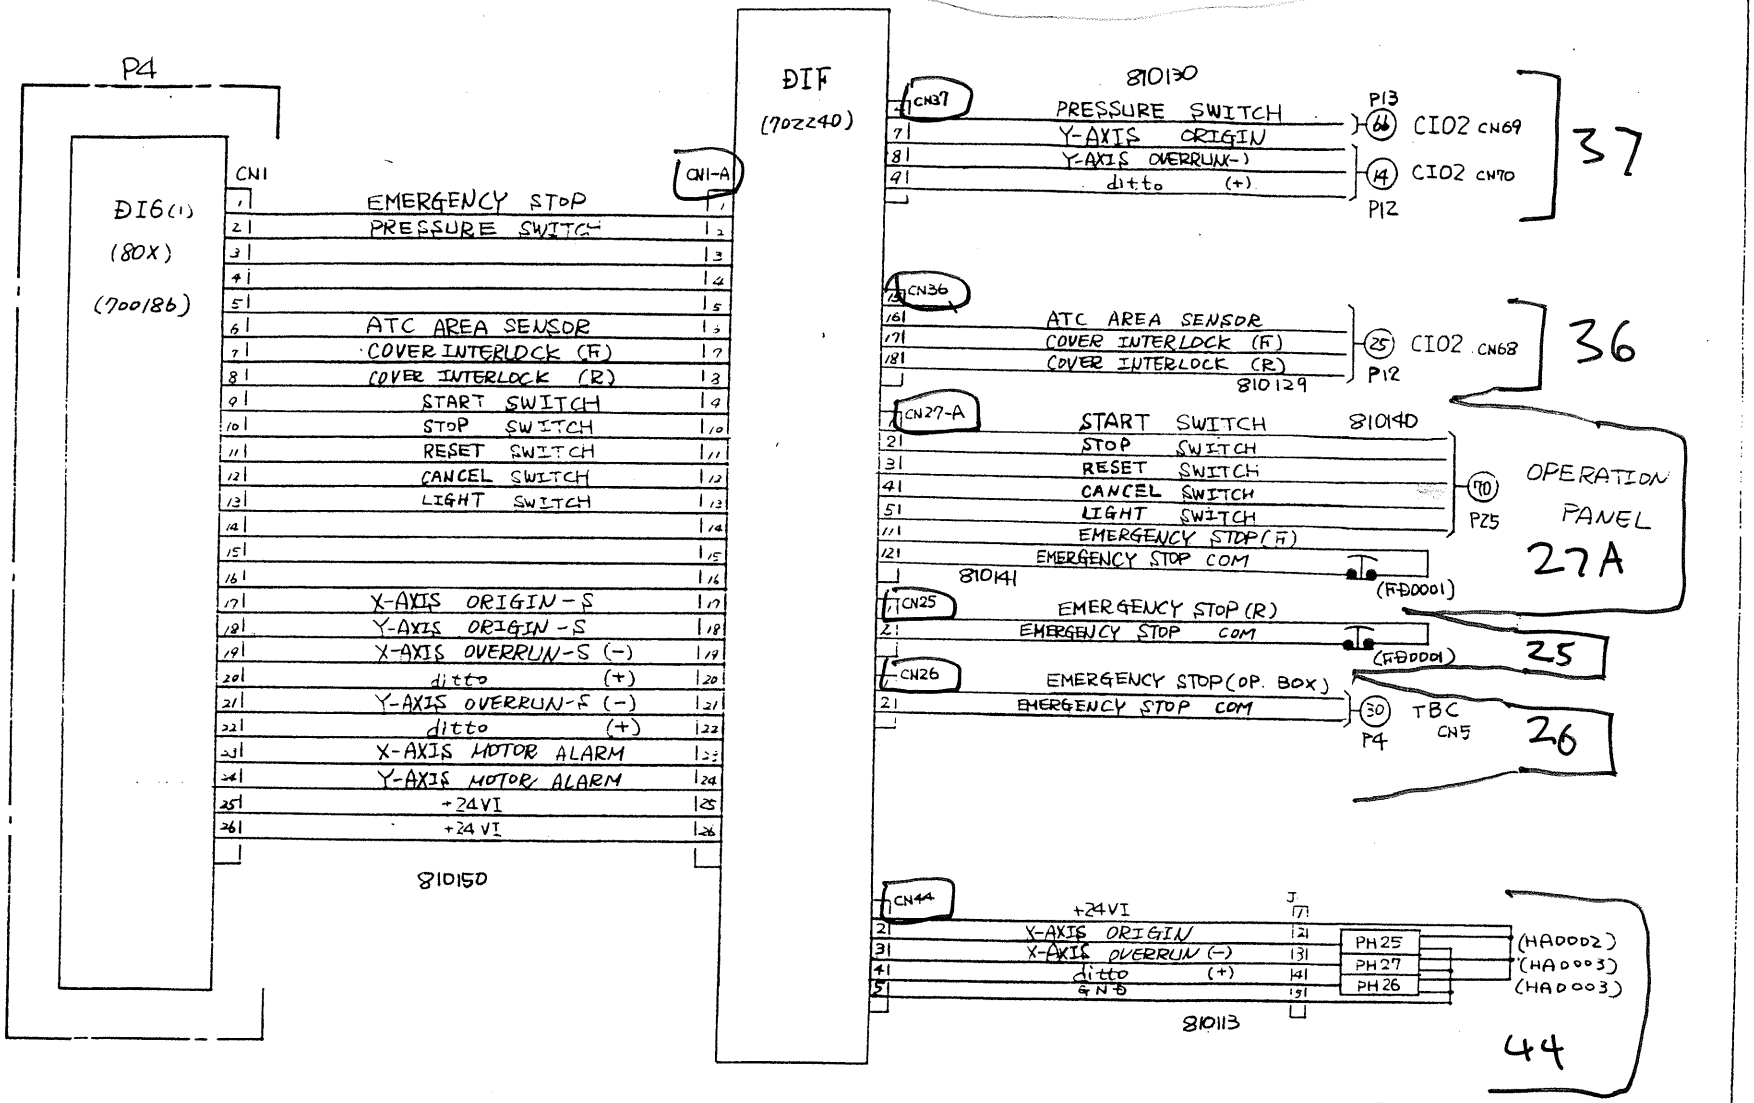


4				MATERIAL	FINISH	DATE 92.12.26
3						DWN BY T.UCHIDA
2				SCALE	3RD ANGLE PROJECTION	APPD BY / DSNG BY T. Suzuki
1	REVISIONS	DATE	REVD			CHKD BY M.KURATA
Tenryu Technics				TITLE MT-5600SQ ELEC. CIRCUIT DWG.	DWG. NO. 910073	14/25

Data In board

OPERATION BOX + SENSORS
CLAMP SENSORS, XY OVERRUN

1-B, 27, 36, 37, 44, 43, 7
41 8

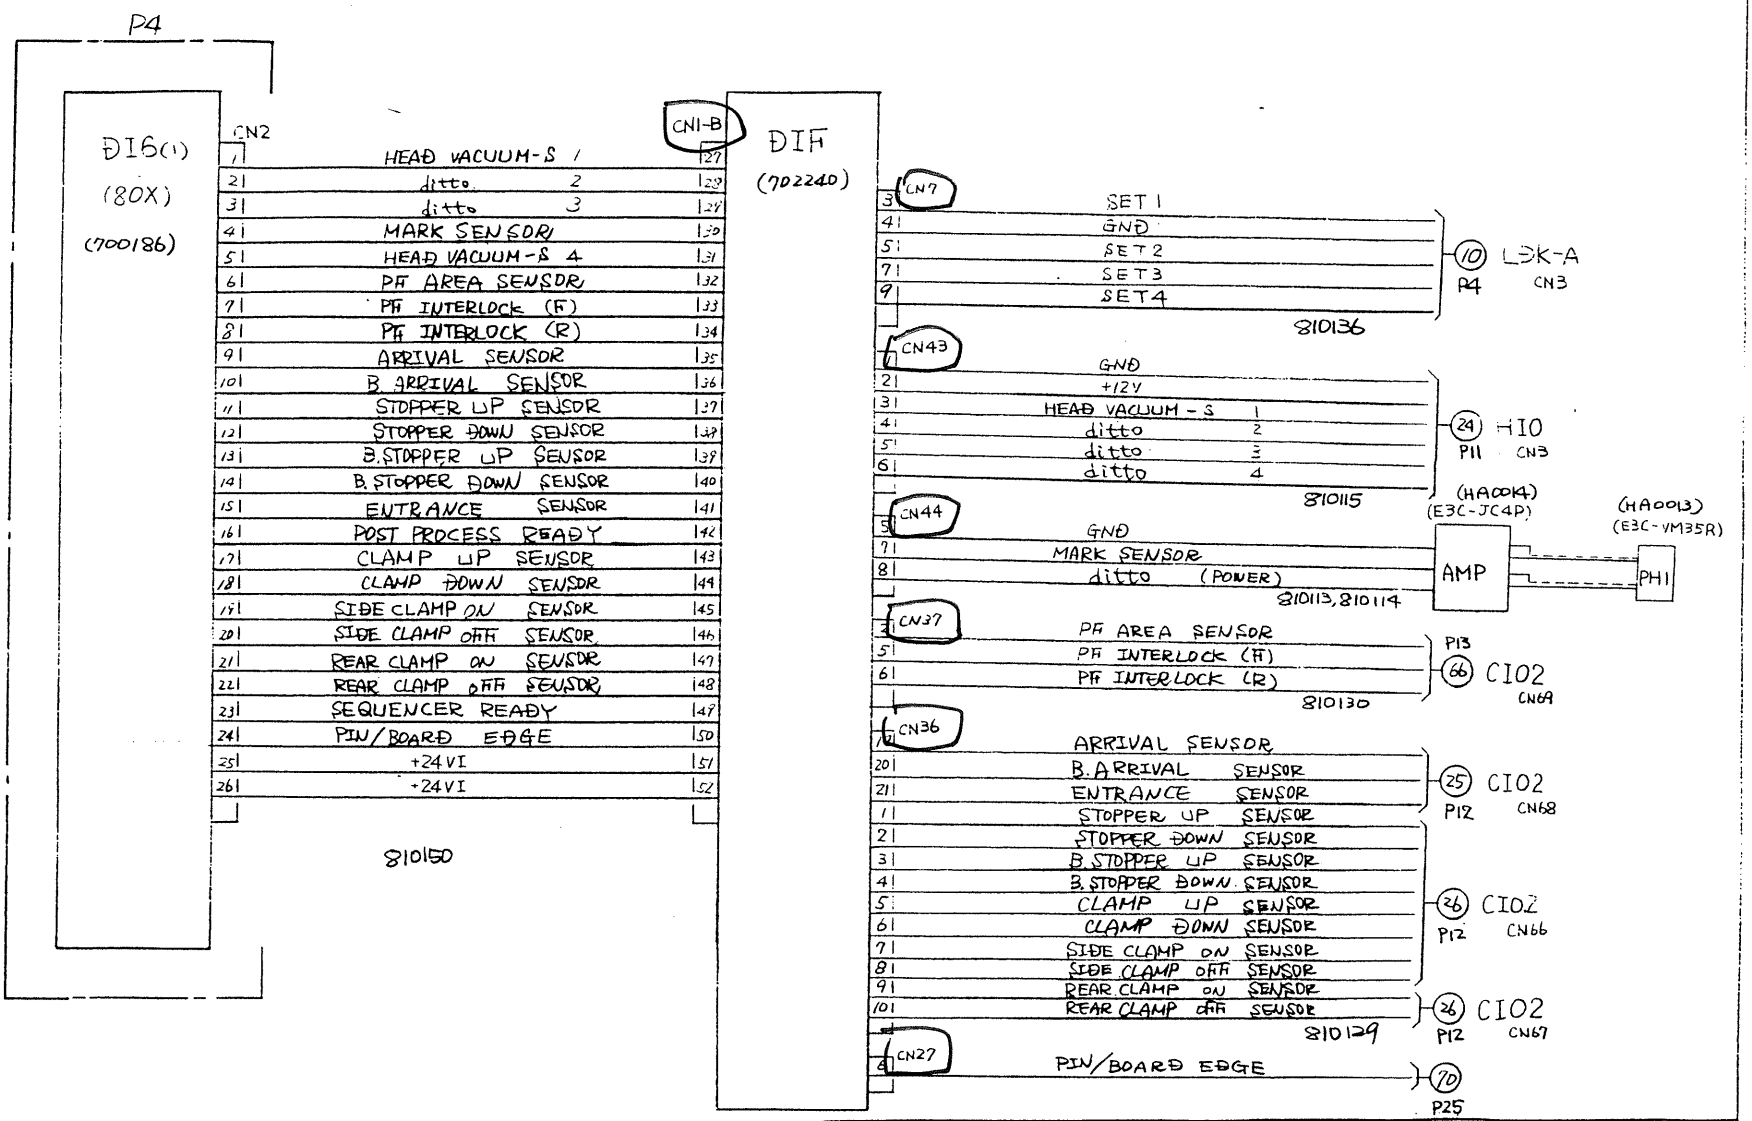


REVISIONS	DATE	REVD	MATERIAL	FINISH	DATE 92·12·26
					DWN BY T. UCHIDA
			SCALE /	3RD ANGLE PROJECTION	APPD BY
					DSNG BY J. Suzuki
					CHKD BY M. KURATA
Tenryu Technics			TITLE MT-5600SG ELEC. CIRCUIT DWG		DWG. NO. 910073 15/25

Data in Board

HEAD, ANC SENSORS

2-A, 42, 52

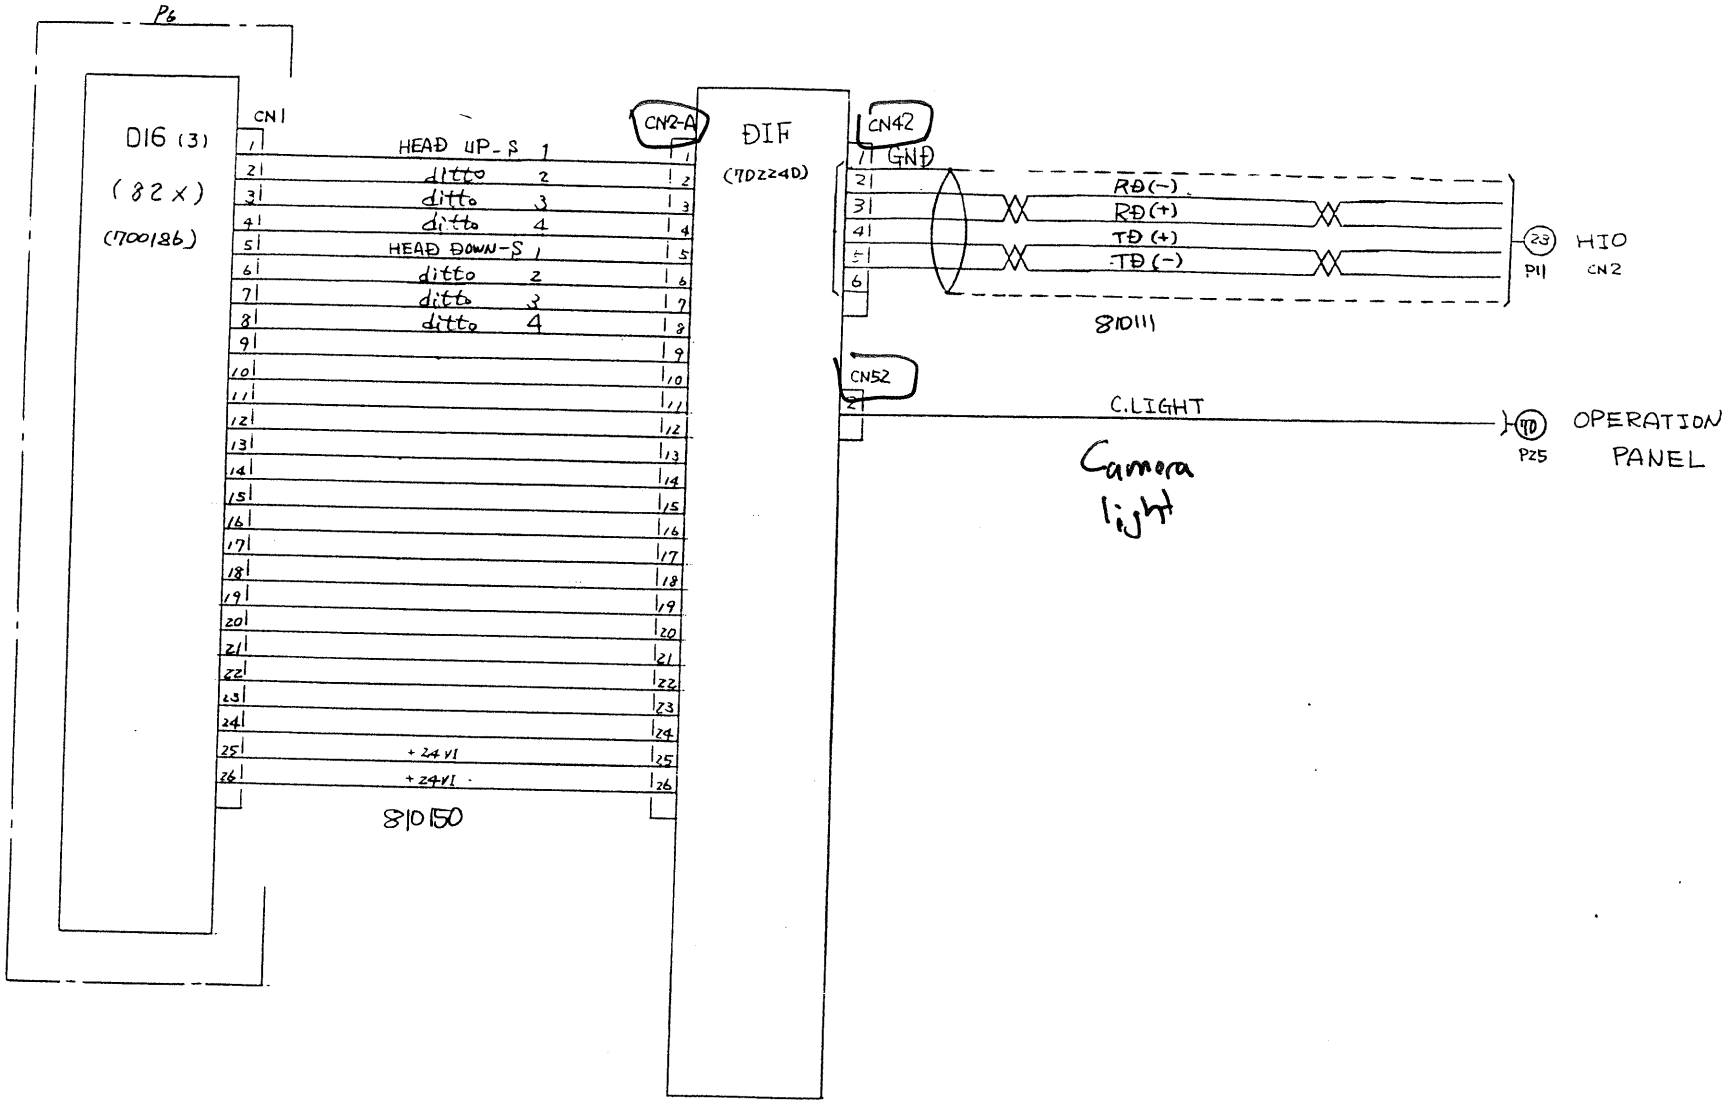

REVISIONS	DATE	REL'D	MATERIAL	FINISH	DATE 92 12 26
					DWN BY T.UCHIDA
			SCALE /	3RD ANGLE PROJECTION	APPD BY
					DSNG BY T. Suzuki
					CHKD BY M.KURATA

Tenryu Technics


TITLE MT-5600SQ ELEC. CIRCUIT DWG.

DWG. NO. 910073

16/25

2-B, 46, 47, 27-B

data in board

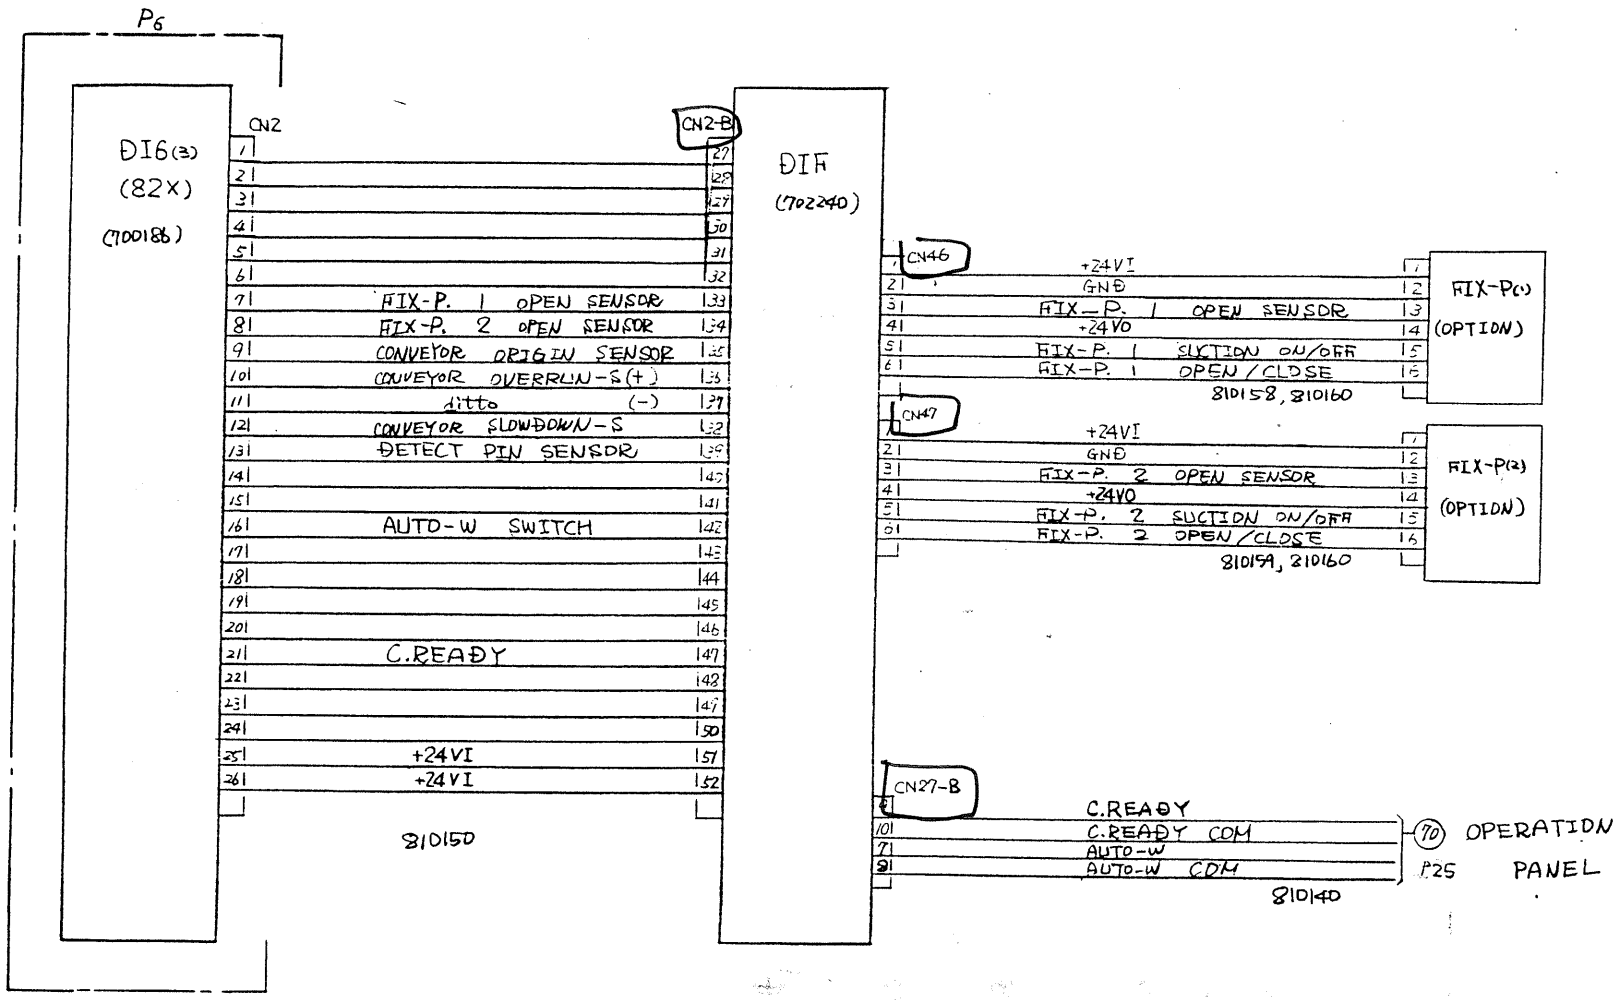

REVISIONS	DATE	REVD	MATERIAL	FINISH	DATE 92·12·26
					DWN BY T.UCHIDA
			SCALE /	3RD ANGLE PROJECTION	APPD BY
					DSNG BY J. Suzuki
					CHKD BY M. KURATA


Tenryu Technics

TITLE MT-5600SQ ELEC. CIRCUIT DWG.


DWG. NO. 910073

17/25

OLD SERVO CABLE (YASKAWA) from DIF

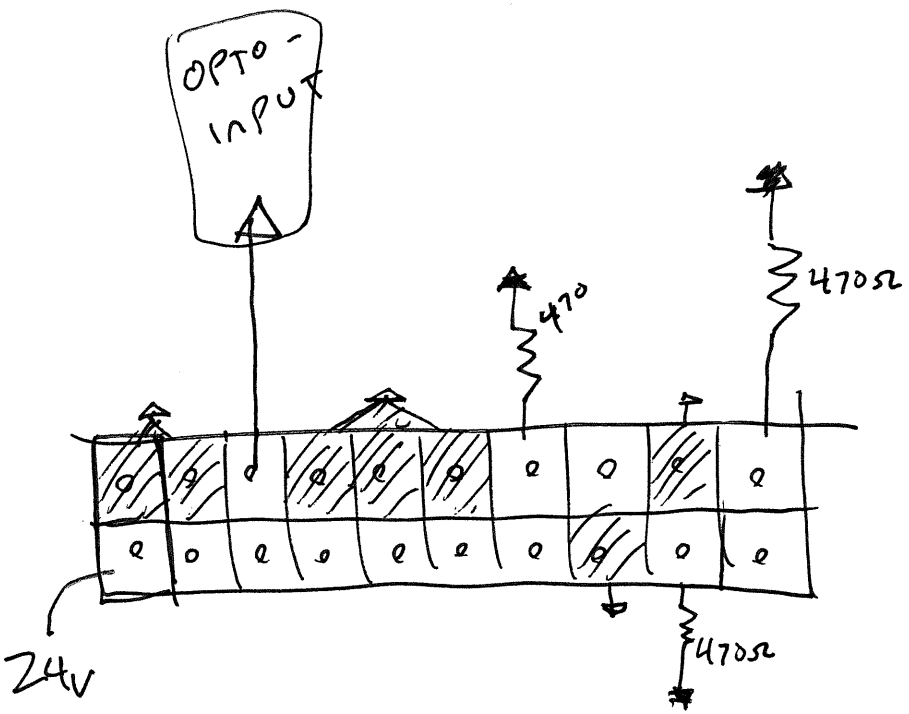

Front (look at board)

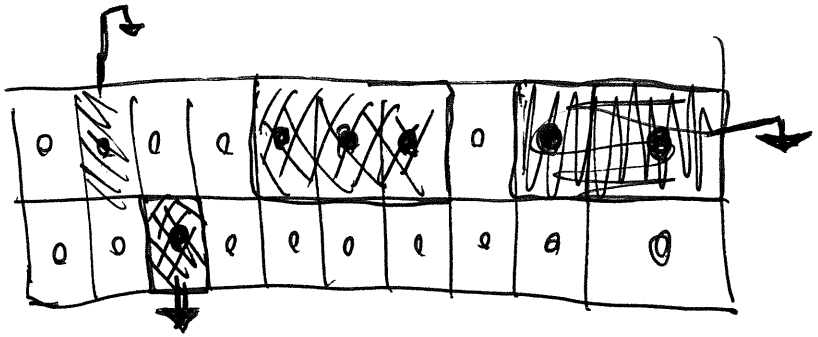

Axis (bottom)

out